
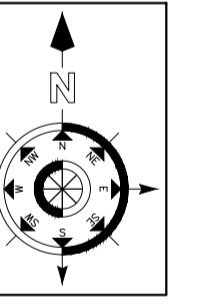


GREENSWOOD PHASE 1

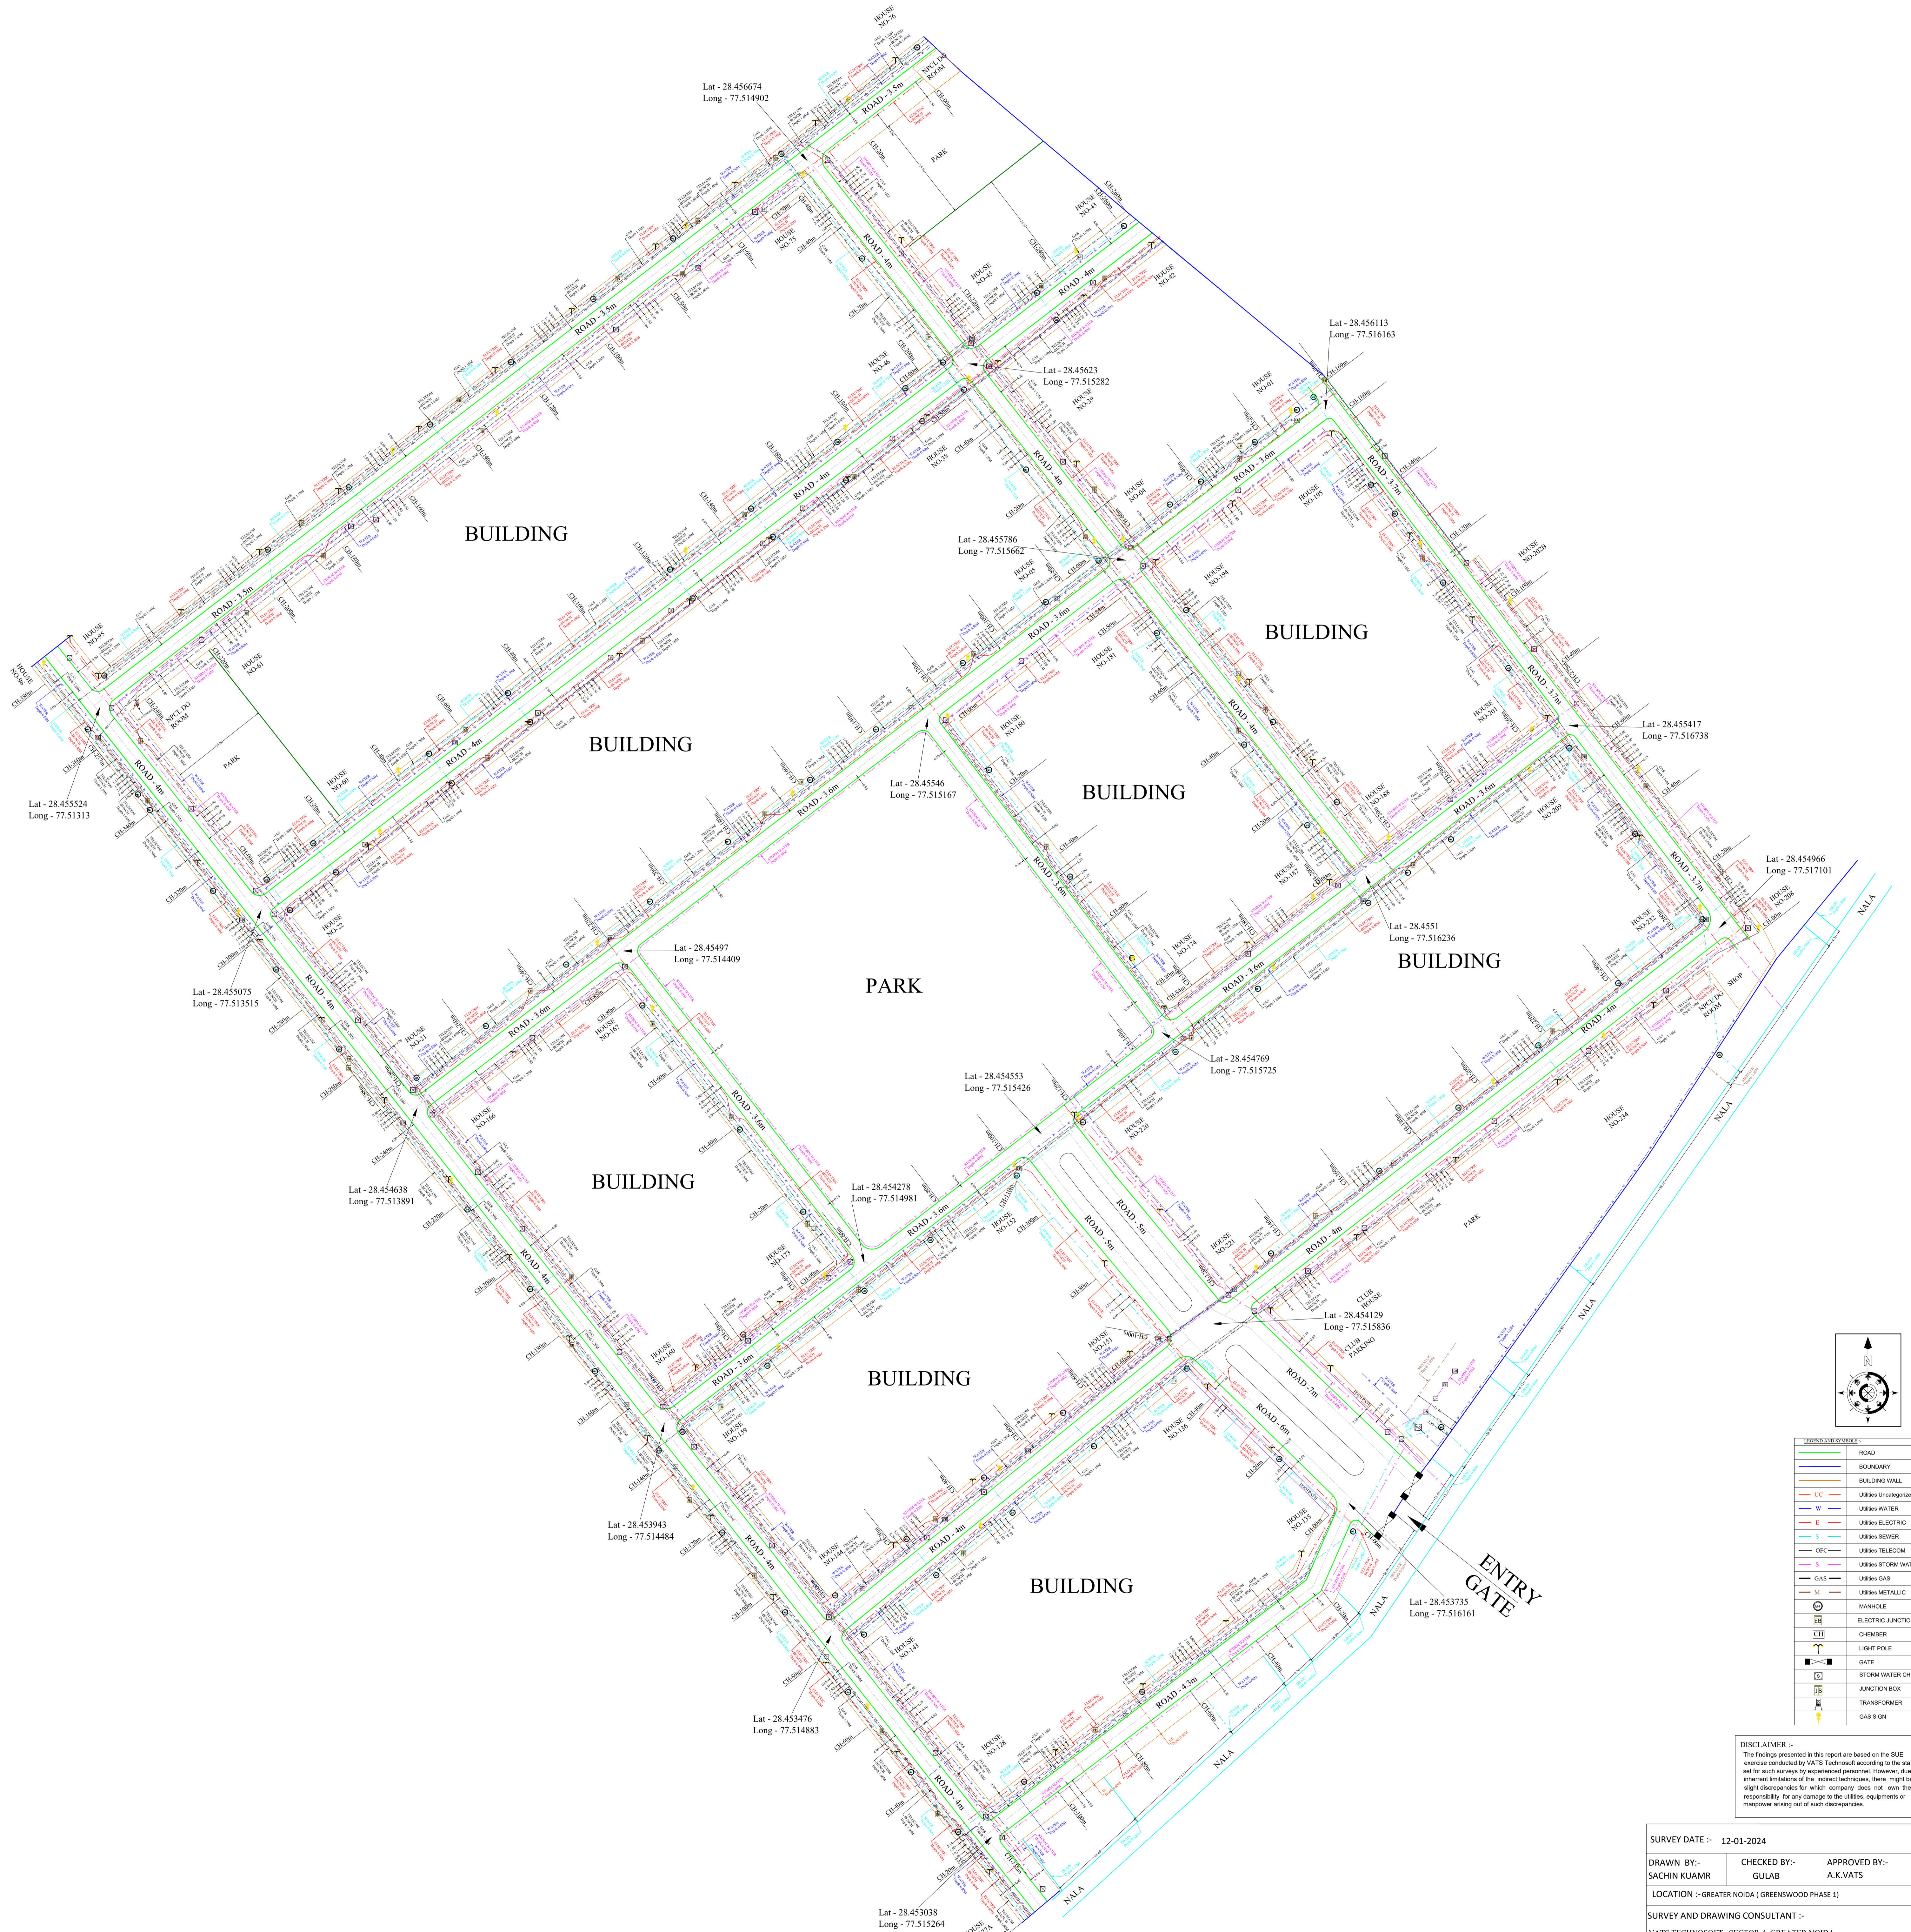

LEGEND AND SYMBOLS	
[Green Line]	ROAD
[Blue Line]	BOUNDARY
[Red Line]	BUILDING WALL
[Orange Line]	LI
[Yellow Line]	LI (Unsubscribed)
[Blue Line]	LI (Water)
[Red Line]	LI (Electric)
[Green Line]	LI (Gas)
[Purple Line]	LI (Storm Water)
[Black Line]	LI (Metallic)
[Circle]	MANHOLE
[Square]	ELECTRIC JUNCTION BOX
[Triangle]	CHEMBER
[Star]	LIGHT POLE
[Arrow]	GATE
[Square]	STONE WATER CHEMBER
[Circle]	JUNCTION BOX
[Square]	TRANSFORMER
[Star]	GAS SIGN

DISCLAIMER :-
The findings presented in this report are based on the SUE review conducted by VATS Technosoft according to the standards set for such surveys by experienced personnel. However, due to inherent limitations of the indirect techniques, there might be slight discrepancies for which company does not own the responsibility. No any damage to the utilities, equipments or manpower arising out of such discrepancies.

SURVEY DATE :- 12-01-2024		
DRAWN BY :- SACHIN KUAMR	CHECKED BY :- GULAB	APPROVED BY :- A.K.VATS
LOCATION :- GREATER NOIDA (GREENSWOOD PHASE 1)		
SURVEY AND DRAWING CONSULTANT :-		
VATS TECHNO-SOFT, SECTOR-4, GREATER NOIDA (Mob.-9810105287)		
PROJECT TYPE :- GPS SURVEY	ICG/DRW	REV. 00
		SHEET NO. 01/01